


DRAWING MADE IN THIRD ANGLE PROJECTION

© COPYRIGHT 1977, BY AMP INCORPORATED, HARRISBURG, PA.  
 ALL INTERNATIONAL RIGHTS RESERVED. AMP INCORPORATED PRODUCTS  
 COVERED BY U. S. AND FOREIGN PATENTS AND/OR PATENTS PENDING.

- ③ 207438-2 1. AS SHOWN.
  - 207438-3 1. SAME AS -2 EXCEPT:
  - 207438-5 2. LOOSE PIECE
- ~~③ 207438-5 1. SAME AS -2 EXCEPT:~~  
~~2. LOOSE PIECE~~

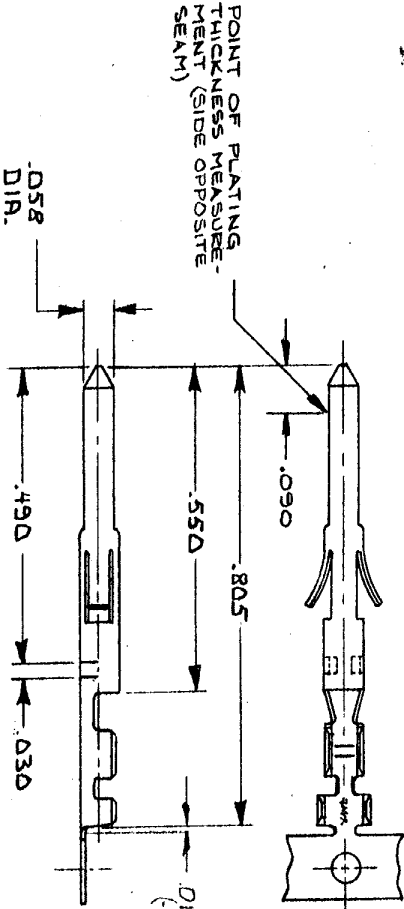

③ -8 DID MAX CUTOFF (-3, S, -7 & -9 ONLY)

- ③ -8 1. SAME AS -9 EXCEPT:
- 2. GOLD FLASH/ILL. PLATED.
- 9 1. SAME AS -8 EXCEPT:
- 2. LOOSE PIECE.

- 9 1. SAME AS -8 EXCEPT:
- 2. SELECT GOLD/ILL. PLATED.
- 10 1. SAME AS -9 EXCEPT:
- 2. LOOSE PIECE.

REVISIONS		DATE	APPROVED
F	ZONE		
G	08SOLATED -5 / ECU R -2G13	1-3-87	RG AT
H	REV PER EC 0020 - 289-93	5-1-88	RK

UNLESS OTHERWISE SPECIFIED DIMENSIONS ARE TO BE IN DECIMALS INCHES		CONTRACT NO.		NAME	
DRAWING NO. 207438		AMP INCORPORATED		AMP INCORPORATED	
MATERIAL BRASS		DATE 1/3/77		HARRISBURG, PA.	
FINISH STAIN WHITE		APPROVED BY [Signature]		DRAWING NO. 207438	
DESIGN APPR. [Signature]		OTHER APPR.		SCALE 1:051	
PART NO.		CONTRACT, PIN		SHEET 1 OF 1	

CUSTOMER DRAWING

AMP 1270-15 Q-73