


MADE IN AMERICA PROJECTION

BY AMP INCORPORATED. ALL RIGHTS RESERVED. REPRODUCED OR TRANSMITTED IN ANY FORM OR BY ANY MEANS WITHOUT WRITTEN PERMISSION OF AMP INCORPORATED.

REVISIONS

LTR	DESCRIPTION	DATE	APPROVED
O	NPS 74-0337	pm 6-4-74	Jm
A	REVISED ECN P-7424	pm 12/20/74	L.D.
B	INACT P9268	12-13-82	Jm
C	OBS -4 REV G 2589	BT 10-12-87	Jm

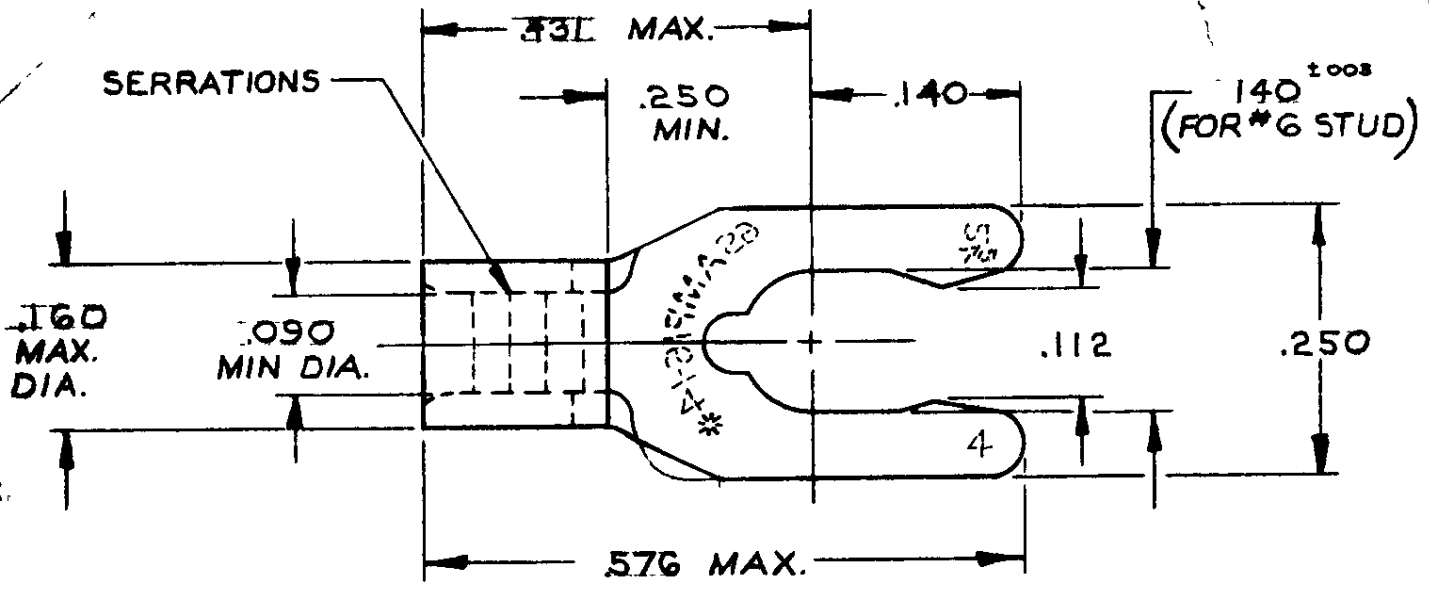

INACTIVE
P9268
Jm
12-13-82

~~ENGINEERING CONTROLLED~~

~~OBSOLETE~~ ~~53010-4~~ 53010-3

PART NO ON TAPE PART NO

UNLESS OTHERWISE SPECIFIED DIMENSIONS ARE IN INCHES
TOLERANCES ON:
DECIMALS ±.008
ANGLES ± 5°

CONTRACT NO. H
DR. Phil Monaghan 5-30-74



AMP INCORPORATED
HARRISBURG, PENNSYLVANIA

MATERIAL
PHOSPHOR
COPPER
(MIL-E-576)
TIN RELATED
(MIL-T-1072)

CHK Jm Enominger 6-4-74
APPD Les Abel 6-5-74
REL Phil Monaghan 6-5-74

NAME
WIRE TERMINAL
BUDGET - SPRING SPADE (SHORT)
WIRE SIZE: 16-14

DSGN APPD JLBrown 6-4-74
OTHER APPD

SIZE A CODE IDENT NO. 00779 NUMBER 53010

SCALE NTS SHEET 1 OF 1