


PROPERTY OF TYCO ELECTRONICS
 CUST. DWG. NO. 1437532-1 REV. 99


MARKED UP
 PRINT
 K. WRIGHT
 5/8/03

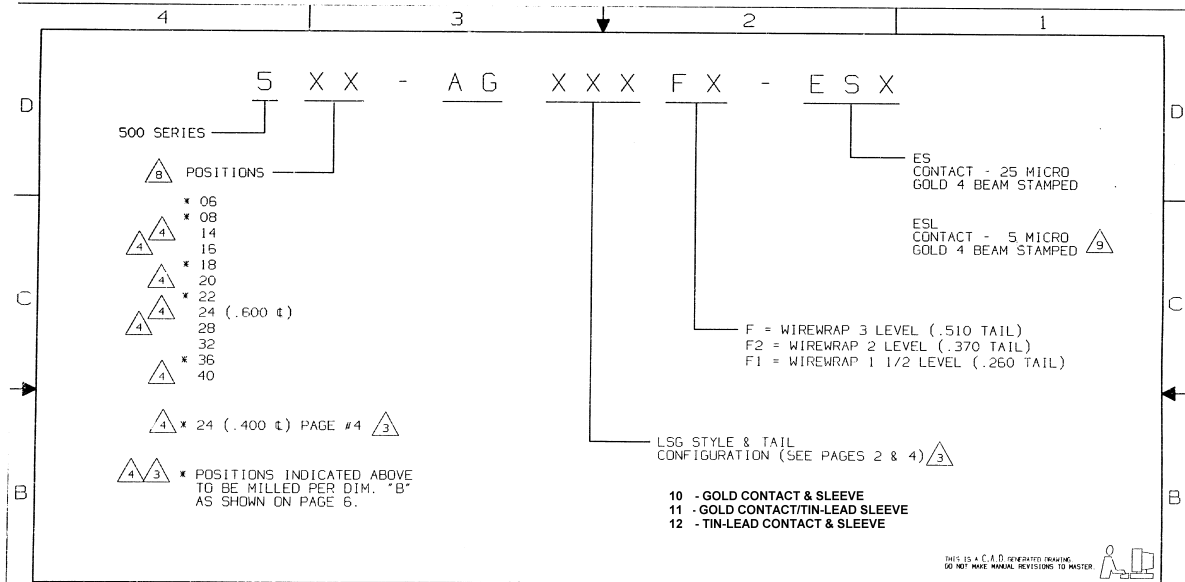


REV	REVISIONS
1	DESIGN & DRAWING D. SANTOS 8-10-87
2	REVISED D. SANTOS 8-27-87
3	REVISED D. SANTOS 11-23-87
4	REVISED D. SANTOS 2-25-90
5	REVISED D. SANTOS 4-2-90
6	REVISED D. SANTOS 9-17-91
7	REVISED D. SANTOS 9-15-95
8	REVISED D. SANTOS 10-20-95
9	REVISED D. SANTOS 10-24-95
10	REVISED D. SANTOS 11-29-96
11	REVISED D. SANTOS 1-16-99
12	REVISED D. SANTOS 7/18/02

UNLESS OTHERWISE SPECIFIED DIMENSIONS ARE IN INCHES DO NOT SCALE PRINT	ORIGINAL DATE 8-10-87	 452 JOHN DICKSON BLVD. ATLEBORO FALLS, MASS. 02763 INC.
FILE NAME: DIRECTORY: PROJECT: SBOOMPS: PROCEAS	DRAWN: D. SANTOS 8-10-87	
AUGAT CONFIDENTIAL	CHECKED: REV. 6 RAY-D 12-23-92	TITLE: ASSEMBLY SOCKET (.260, .370, .510 WW TAIL)
This document contains information which is the exclusive property of Augat Inc. Distribution, reproduction or use by others is not permitted without the expressed written	APPROVED: A. CORRIDORI 8-27-87	DWG. NO. 500-ASXXXFX-ES, ESL
	CODE IDENT. NO. 91506	REV. 9
	DWG. SIZE B	PRODUCT CODE: 159

MARKED UP
PRINT
K. WRIGHT
5/8/03

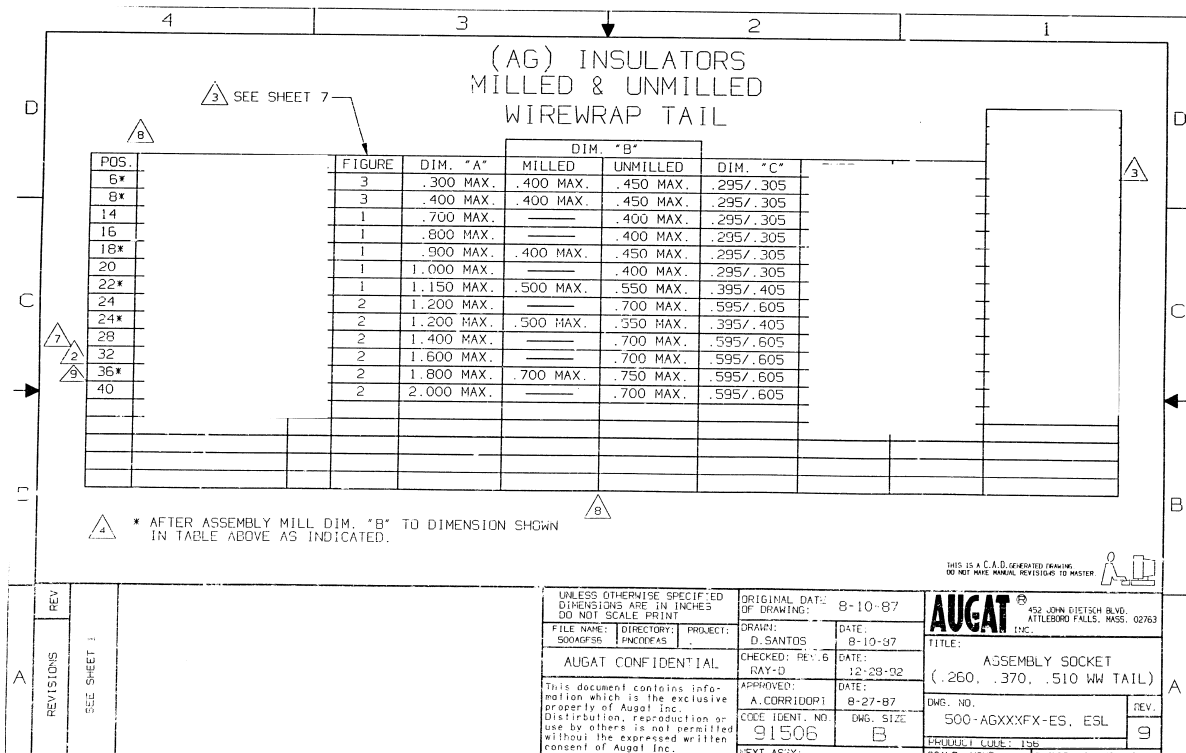

MARKED UP
 PRINT
 K. WRIGHT
 5/8/03

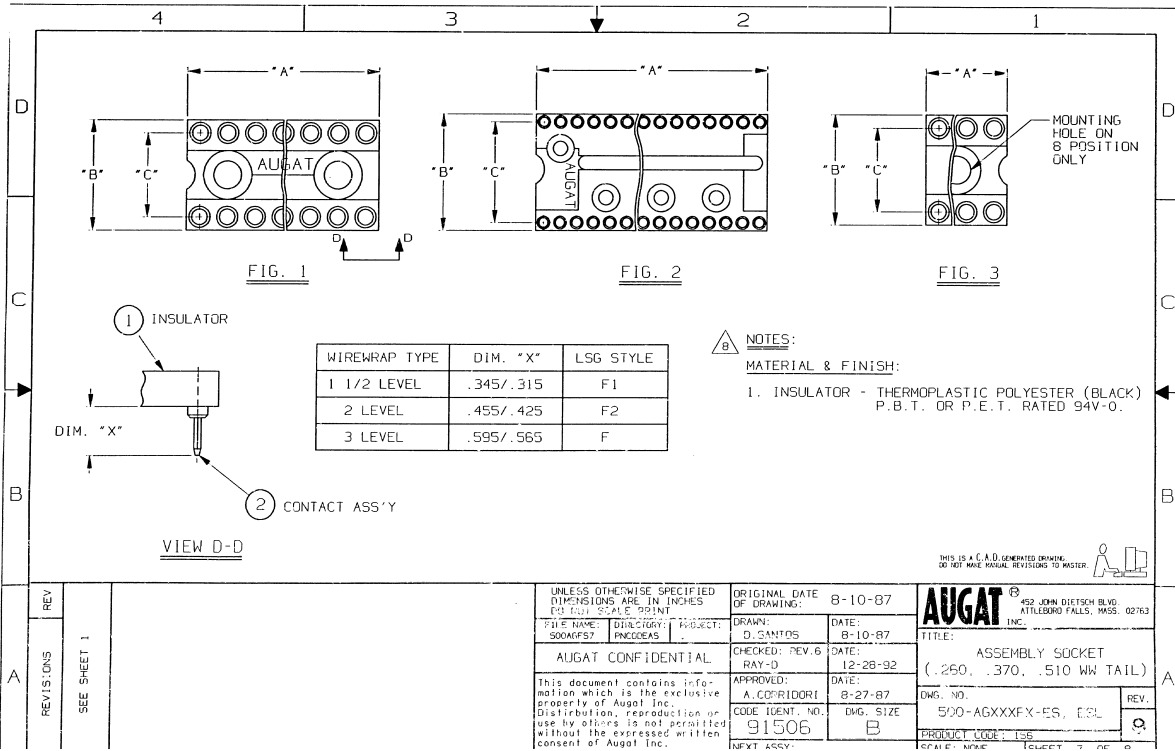

A	REV	REVISIONS	REV	DATE	BY	DESCRIPTION	UNLESS OTHERWISE SPECIFIED DIMENSIONS ARE IN INCHES DECIMALS TO TWO PLACES FRACTIONS TO 32ND POINT	ORIGINAL DATE OF DRAWING: 8-10-87	AUGAT 452 JOHN DITSCHE BLVD ATLEBORO FALLS, MASS. 02763 INC.
								FILE NAME: 5000GFS7 DIRECTION: PROCEEDS PROJECT: AUGAT CONFIDENTIAL	
							This document contains information which is the exclusive property of Augat Inc. Distribution, reproduction or use by others is not permitted without the expressed written consent of Augat Inc.	APPROVED: A. COPRIDORI DATE: 8-27-87 CODE IDENT. NO.: 91506 DWG. SIZE: B	DWS: 10 500-AGXXXX-ES, ECL PRODUCT CODE: 136