THIS DRAWING IS UNPUBLISHED. RELEASED FOR PUBLICATION APR ,1988.
© COPYRIGHT 1988 BY TYCO ELECTRONICS CORPORATION. ALL RIGHTS RESERVED.

LOC	DIST
J	

REVISIONS (変更)

P	LTR	DESCRIPTION	DATE	DWN	APVD
	F1	REV PER ECO-10-000443	15JAN10	KK	AEG

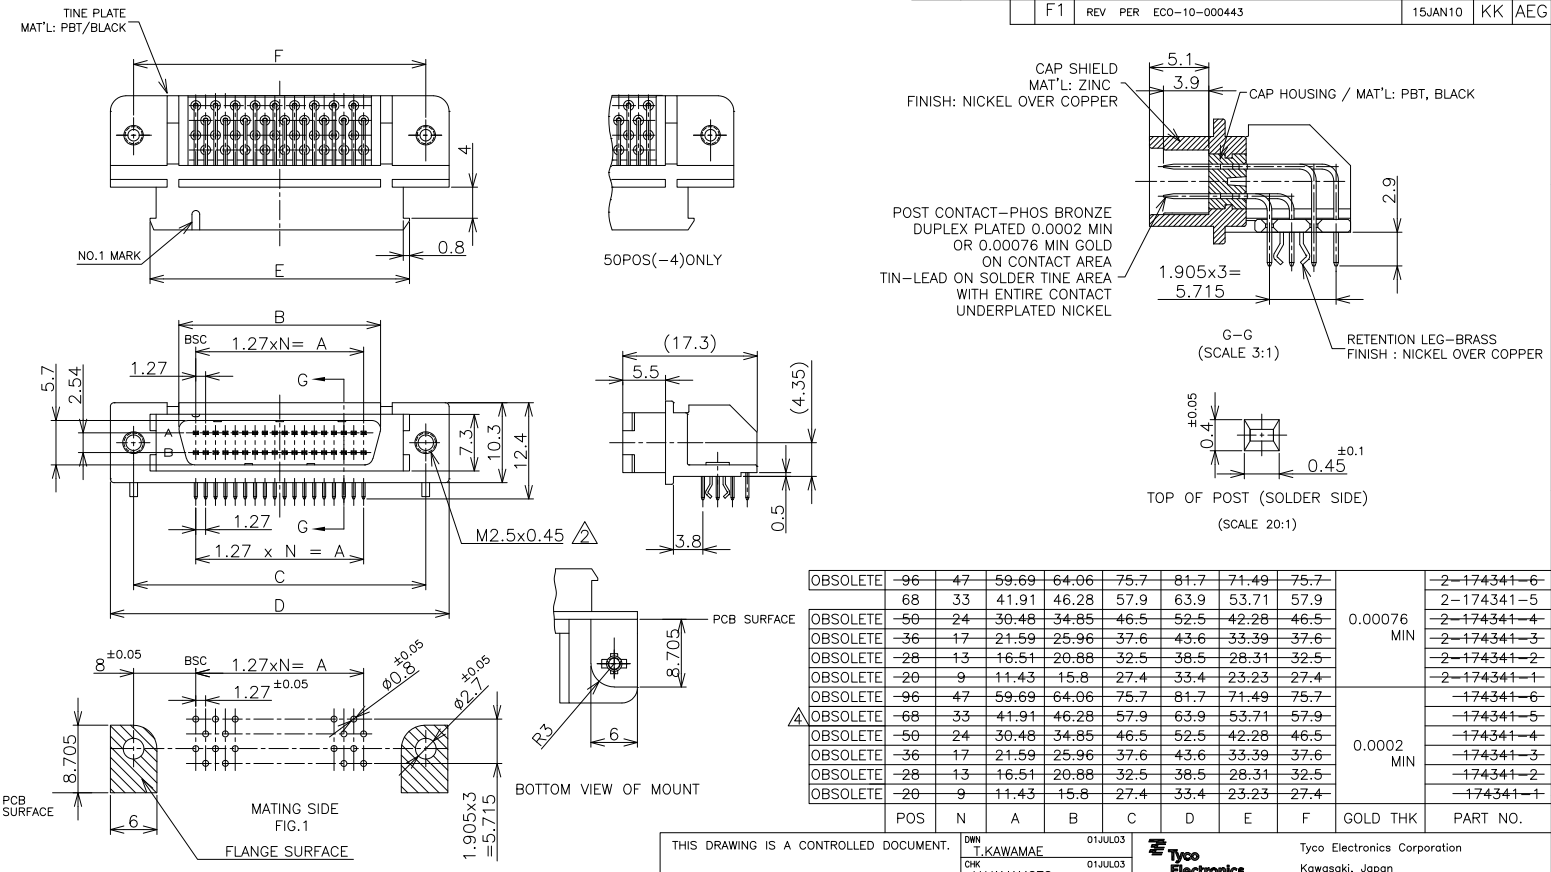

	POS	N	A	B	C	D	E	F	GOLD THK	PART NO.
OBSOLETE	~~96~~	~~47~~	~~59.69~~	~~64.06~~	~~75.7~~	~~81.7~~	~~71.49~~	~~75.7~~	0.00076 MIN	~~2-174341-6~~
	68	33	41.91	46.28	57.9	63.9	53.71	57.9		2-174341-5
OBSOLETE	~~50~~	~~24~~	~~30.48~~	~~34.85~~	~~46.5~~	~~52.5~~	~~42.28~~	~~46.5~~		~~2-174341-4~~
OBSOLETE	~~36~~	~~17~~	~~21.59~~	~~25.96~~	~~37.6~~	~~43.6~~	~~33.39~~	~~37.6~~		~~2-174341-3~~
OBSOLETE	~~28~~	~~13~~	~~16.51~~	~~20.88~~	~~32.5~~	~~38.5~~	~~28.31~~	~~32.5~~		~~2-174341-2~~
OBSOLETE	~~20~~	~~9~~	~~11.43~~	15.8	~~27.4~~	~~33.4~~	~~23.23~~	~~27.4~~		~~2-174341-1~~
OBSOLETE	~~96~~	~~47~~	~~59.69~~	~~64.06~~	~~75.7~~	~~81.7~~	~~71.49~~	~~75.7~~	0.0002 MIN	~~174341-6~~
4 OBSOLETE	~~68~~	~~33~~	~~41.91~~	~~46.28~~	~~57.9~~	~~63.9~~	~~53.71~~	~~57.9~~		~~174341-5~~
OBSOLETE	~~50~~	~~24~~	~~30.48~~	~~34.85~~	~~46.5~~	~~52.5~~	~~42.28~~	~~46.5~~		~~174341-4~~
OBSOLETE	~~36~~	~~17~~	~~21.59~~	~~25.96~~	~~37.6~~	~~43.6~~	~~33.39~~	~~37.6~~		~~174341-3~~
OBSOLETE	~~28~~	~~13~~	~~16.51~~	~~20.88~~	~~32.5~~	~~38.5~~	~~28.31~~	~~32.5~~		~~174341-2~~
OBSOLETE	~~20~~	~~9~~	~~11.43~~	~~15.8~~	~~27.4~~	~~33.4~~	~~23.23~~	~~27.4~~		~~174341-1~~

1 P.C BOARD HOLE LAY-OUT AS SHOWN FIG.1
2 USED SCREW SIZE; M2.5 PANHEAD SCREW
3 CONNECTOR TO BE MATED;
X-174340-X
4 OBSOLETE PARTS: OBSOLETE CIS STREAMLINING PER D.RENAUD/D.SINISI

GENERAL TOLERANCE
10 ≧ : ±0.2
30 ≧ > 10: ±0.25
100 ≧ > 30: ±0.3
ANGLES: ±3°

THIS DRAWING IS A CONTROLLED DOCUMENT.

DIMENSIONS: 単位: 耗 mm
TOLERANCES UNLESS OTHERWISE SPECIFIED: 一般公差
0 PLC ±
1 PLC ±
2 PLC ±
3 PLC ±
4 PLC ±
ANGLES ±
MATERIAL 材料: SEE ABOVE
FINISH 仕上: SEE ABOVE

DWN T.KAWAMAE 01JUL03
CHK Y.YAMAMOTO 01JUL03
APVD Y.YAMAMOTO 01JUL03
PRODUCT SPEC 製品規格: 108-5238-1
APPLICATION SPEC 取付適用規格:
WEIGHT:
CUSTOMER DRAWING

Tyco Electronics
Tyco Electronics Corporation
Kawasaki, Japan

NAME 名称: POST HEADER HORIZONTAL, WITH R/L AMPLIMITE .050 SERIES II CONN. TYPE B

SIZE	CAGE CODE	DRAWING NO 番号	RESTRICTED TO
A3	00779	C-174341	

SCALE 尺度 2:1 SHEET 1 OF 1 REV F1

AMP 1470-19 REV 31MAR2000

Downloaded from Elcodis.com electronic components distributor