THIS DRAWING IS UNPUBLISHED. RELEASED FOR PUBLICATION

© COPYRIGHT 2009 BY TYCO ELECTRONICS CORPORATION. ALL INTERNATIONAL RIGHTS RESERVED.

LOC	DIST
AI	

REVISIONS

P	LTR	DESCRIPTION	DATE	DWN	APVD
	Y2	Released as per ECR-09-017573	10.Aug.09	SRE	PCH
	Y3	REVISED PER ECO-09-023929	23OCT09	KK	AEG

GEGENSTECKER/KONTAKT: [X] 825 440 [X] 167 301-4
MATED WITH:

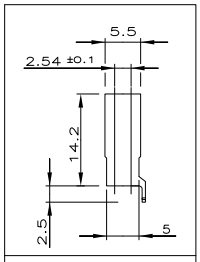

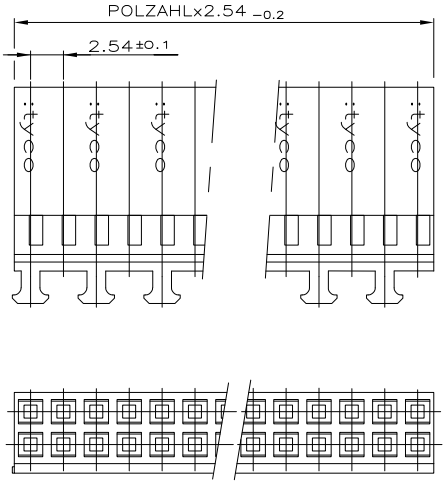

RAST-NOPPENSTELLUNG WECHSELT PRODUKTIONSBEDINGT.
NOPPEN VERRASTEN ENTSPRECHEND LINKS ODER RECHTS MIT STIFTLEISTE.

POSITIONS OF LOCKING DEVICE CHANGED CONDITIONAL OF PRODUCTION.
KNUPS LOCK ACCORDING ON THE LEFT OR RIGHT SIDE WITH PIN HEADER.

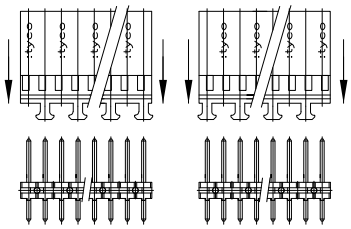

ZWEIREIHIG

POLZ. PRO REIHE	L-0.2	BESTELL-NR.		
-	-			-
2	5.08	925 370	-2	
3	7.62		-3	
4	10.16		-4	
5	12.70		-5	
6	15.24		-6	
7	17.78		-7	
8	20.32		-8	
9	22.86		-9	
10	25.40	1-	-0	
11	27.94	1-	-1	
12	30.48	1-	-2	
13	33.02	1-	-3	
14	35.56	1-	-4	
15	38.10	1-	-5	
16	40.64	1-	-6	
17	43.18	1-	-7	
18	45.72	1-	-8	
19	48.26	1-	-9	
20	50.80	2-	-0	
21	53.34	~~2-~~	~~1-~~	OBSOLETE ⚠1
22	55.88	~~2-~~	~~2-~~	
23	58.42	~~2-~~	~~3-~~	
24	60.96	2-	-4	
25	63.50	~~2-~~	~~5-~~	OBSOLETE ⚠1
26	66.04	~~2-~~	~~6-~~	
27	68.58	~~2-~~	~~7-~~	
28	71.12	~~2-~~	~~8-~~	
29	73.66	~~2-~~	~~9-~~	
30	76.20	3-	-0	
31	78.74	~~3-~~	~~1-~~	OBSOLETE ⚠1
32	81.28	3-	-2	
33	83.82	~~3-~~	~~3-~~	OBSOLETE ⚠1
34	86.36	3-	-4	
35	88.90	~~3-~~	~~5-~~	OBSOLETE ⚠1
36	91.44	~~3-~~	~~6-~~	
37	93.98	~~3-~~	~~7-~~	
38	96.52	~~3-~~	~~8-~~	
39	99.06	~~3-~~	~~9-~~	
40	101.60	~~4-~~	~~0-~~	
41	104.14	~~4-~~	~~1-~~	
42	106.68	~~4-~~	~~2-~~	
43	109.22	~~4-~~	~~3-~~	
44	111.76	~~4-~~	~~4-~~	
45	114.30	~~4-~~	~~5-~~	
46	116.84	~~4-~~	~~6-~~	
47	119.38	~~4-~~	~~7-~~	
48	121.92	~~4-~~	~~8-~~	
49	124.46	~~4-~~	~~9-~~	
50	127.00	5- 925 370	-0	

⚠1 OBSOLETE PARTS: OBSOLETE CIS STREAMLINING PER D.RENAUD/D.SINISI

Drawing valid from CW 32/95
ZEICHNUNG GüLTIG AB KW 32/95

THIS DRAWING IS A CONTROLLED DOCUMENT.

DIMENSIONS: mm

TOLERANCES UNLESS OTHERWISE SPECIFIED:
0 PLC ± 0.2mm
1 PLC ± 0.2mm
2 PLC ± 0.2mm
3 PLC ± 0.2mm
4 PLC ± 0.2mm
ANGLES ± -

MATERIAL: Polyamid
FINISH: Green RAL 6011

DWN 05.12.75 DAHLHEIMER
CHK KREPP
APVD —
PRODUCT SPEC —
APPLICATION SPEC —
WEIGHT —

Tyco Electronics
Tyco Electronics AMP GmbH
Langen b.F fm,Germany

NAME: AMPMODU IV GEHÄUSE, EINREIHIG
Housing, single row

SIZE	CAGE CODE	DRAWING NO	RESTRICTED TO
A3	00779	C-925370	—

CUSTOMER DRAWING | SCALE 2:1 | SHEET 1 OF 1 | REV Y3

1470-19 (1/08)

Downloaded from Elcodis.com electronic components distributor