THIS DRAWING IS UNPUBLISHED. RELEASED FOR PUBLICATION MAR ,1992.
© COPYRIGHT 1992 By – ALL RIGHTS RESERVED.

LOC	DIST
J	–

REVISIONS 変更

P.	LTR	DESCRIPTION	DATE	DWN	APVD
	G3	REVISED PER ECR-11-024209	30NOV11	H.U	N.Y

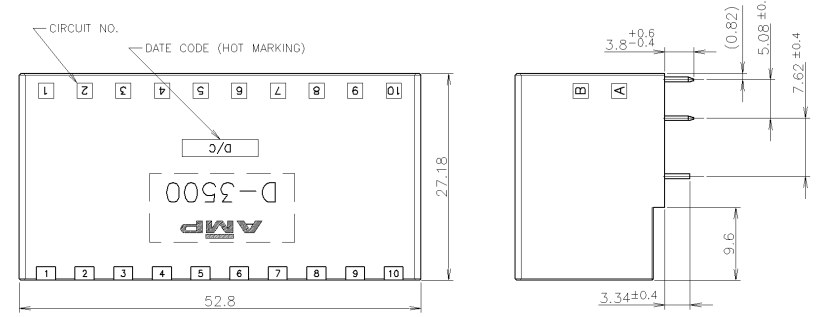

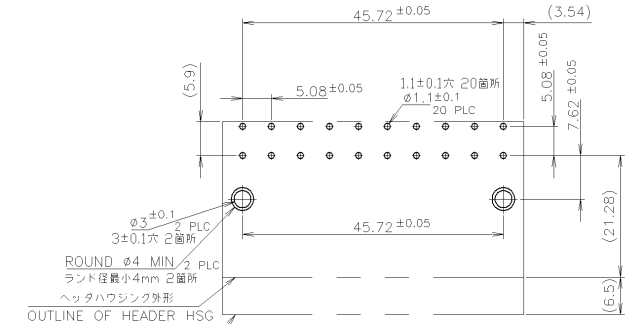

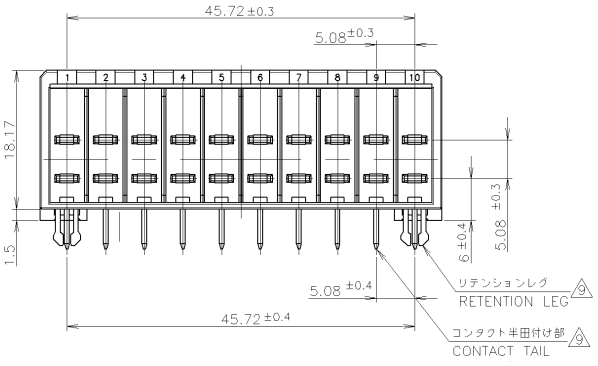

1 材料:熱可塑性ポリエステル樹脂(ガラス入り)
色:黒
2 製品規格:108-5349
3 製品認定報告書:501-5013
4 接触部仕上:ニッケル下地0.38μMIN.金めっき
5 接触部仕上:ニッケル下地0.76μMIN.金めっき
6 接触部仕上:ニッケル下地2.0μMIN.すずめっき
7 ~~レクおよび脚部仕上:ニッケル下地半田めっき~~
8 6箇所マーキング、白
9 レクおよび脚部仕上:ニッケル下地すずめっき

1 MATERIAL; GLASS FIELD THERMO PLASTIC, POLYESTER.
COLOR; BLACK
2 PRODUCT SPEC; 108-5349
3 QUALIFICATION TEST REPORT; 501-5013
4 FINISH (CONTACT AREA); 0.38u MIN. GOLD PLT. OVER NICKEL.
5 FINISH (CONTACT AREA); 0.76u MIN. GOLD PLT. OVER NICKEL.
6 FINISH (CONTACT); 2.0u MIN. TIN PLT. OVER NICKEL.
7 ~~FINISH (RETENTION LEG AND CONTACT TAIL);~~
~~TIN-LEAD PLT. OVER NICKEL.~~
8 6 PLACES MARKING, WHITE
9 FINISH (RETENTION LEG AND CONTACT TAIL); TIN PLT. OVER NICKEL.
10 ~~OBSOLETE PARTS: OBSOLETE CIS STREAMLINING PER D.RENAUD/D.SINISI~~

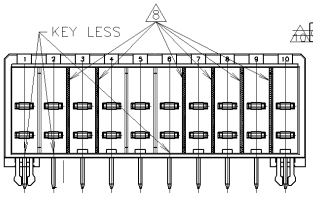

3-175365-2 のみ
ONLY 3-175365-2

10 OBSOLETE	9	4	3-175365-2	8
	9	6	175365-5	
	6	5	175365-3	
	9	4	175365-2	
FINISH			型番 PART NUMBER	マーキング MARKING

GENERAL TOLERANCE 一般公差
10 ≧ : ±0.2
30≧ > 10: ±0.25
100≧ > 30: ±0.3
ANGLES: ±3°

THIS DRAWING IS A CONTROLLED DOCUMENT.

DIMENSIONS: 単位: 粍 mm

TOLERANCES UNLESS OTHERWISE SPECIFIED: 一般公差
0 PLC ±–
1 PLC ±–
2 PLC ±–
3 PLC ±–
4 PLC ±–
ANGLES ±–

MATERIAL 材料: SEE NOTE 注記参照
FINISH 仕上

DWN	T.YONEBAYASHI 18MAR1992
CHK	S.MANABE 07APR1992
APVD	S.MANABE 07APR1992
PRODUCT SPEC 製品規格	
APPLICATION SPEC 取付適用規格	
WEIGHT	
CUSTOMER DRAWING	

TE Connectivity

NAME 名称: DYNAMIC D-3500 20 POS HDR ASSY

SIZE	CAGE CODE	DRAWING NO 番号	RESTRICTED TO
A3	00779	C-175365	–

SCALE 尺度 2:1 SHEET 1 OF 1 REV G3

1470-19 (3/11)

Downloaded from Elcodis.com electronic components distributor